TYPICAL WALL SECTIONS AND DETAILS

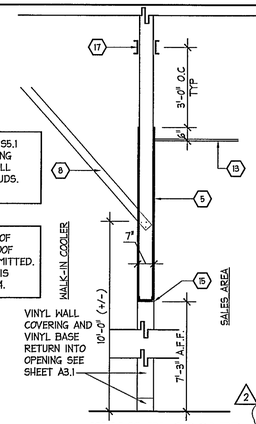

1 NOT USED
A4.1 SCALE:

2 WALK-IN COOLER WALL SECTION
A4.1 SCALE: 3/8"= 1'-0"

GENERAL AND KEYED NOTES FOR WALL SECTIONS AND DETAILS

CONNECTIONS: UNLESS SHOWN OTHERWISE, USE THE FOLLOWING - STUD TO STUD: MIN (2) 1/2" S-12 PAN HEAD SCREWS. STUD TO TRACK: (1) 3/8" S-12 LOW HEAD SCREW AT EACH FLANGE. TRACK TO BACK WALL AND OTHER CONNECTIONS AS SHOWN.

1. BOTTOM CHORD OF STRUCTURAL STEEL BAR JOIST. EXTEND BOTTOM CORD TO PROVIDE FOR FRAMING SUPPORT WHERE REQUIRED.
2. CARRYING 6" METAL STUD, CONTINUOUS.
3. CARRYING 6" METAL STUD, @ 24" O.C. MAX.
4. 3-5/8" VERTICAL METAL STUDS @ 24" O.C. EXTEND AND ATTACH TO BUILDING STRUCTURE ABOVE AS PER DETAILS 16 OR 19.
5. 5/8" DRYWALL (6" ABV FINISHED CEILING IS FOR COOLER/FREEZER OPENING AREA ONLY) EACH SIDE OF 6" METAL STUDS (METAL STUDS TO ROOF DECK)
6. 3-5/8" METAL STUD HORIZONTAL @ 24" O.C.
7. 3-5/8" METAL STUD BRACING @ 24" O.C. ALTERNATE DIRECTIONS.
8. 3-5/8" METAL STUD BRACING @ 48" O.C., SECURE TO BUILDING STRUCTURE ABOVE SIMILAR TO DETAIL 16 OR 19.
9. 3-5/8" METAL TRACK, CONTINUOUS. AT MASONRY, SECURE WITH (2) 3/8" X 2-1/4" WEDGE "RED HEAD" OR "MOLLY BOLT" @ 4'-0" O.C. AT METAL STUD WALLS, USE (2) SELF-DRILLING 3/4" TYPE "S-4" HEX WASHER HEAD AT EACH STUD (24" O.C. MAX.).
10. 3-5/8" METAL TRACK, SNIP INSIDE FLANGE AND ATTACH TO EACH VERTICAL AND HORIZONTAL STUD.
11. 12 GA. MINIMUM GALVANIZED STEEL TIE WIRE.
12. N/A
13. SUSPENDED CEILING, SEE A1.2 RCP.
14. DO NOT ATTACH STUD TO DEFLECTION TRACK TO ALLOW VERTICAL MOVEMENT, FIRE CLOSURE, AND STUD SUPPORT IN ACCORDANCE W/ MANUFACTURER'S STANDARDS.
15. N/A
16. COMPRESSIBLE FILLER.
17. PROVIDE HORIZONTAL 3-5/8" METAL STUD BRACING (3'-0" O.C.) EACH SIDE, WHERE STUDS ARE EXPOSED

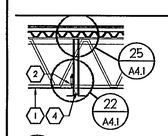

16 DETAIL
A4.1 SCALE: 1/4"= 1'-0"
SUSPENSION OF FRAMING FOR FASCIA PERPENDICULAR TO ROOF FRAMING.

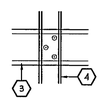

17 DETAIL
A4.1 SCALE: 1"= 1'-0"

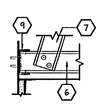

18 DETAIL
A4.1 SCALE: 1"= 1'-0"

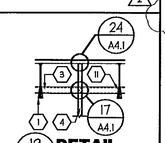

19 DETAIL
A4.1 SCALE: 1/4"= 1'-0"
SUSPENSION OF FRAMING FOR FASCIA PARALLEL TO ROOF FRAMING.

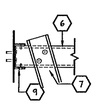

20 DETAIL
A4.1 SCALE: 1"= 1'-0"

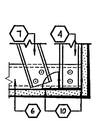

21 DETAIL
A4.1 SCALE: 1"= 1'-0"

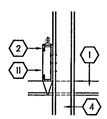

22 DETAIL
A4.1 SCALE: 1"= 1'-0"

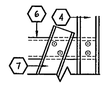

23 DETAIL
A4.1 SCALE: 1"= 1'-0"

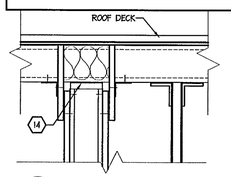

24 DETAIL
A4.1 SCALE: 1 1/2"= 1'-0"

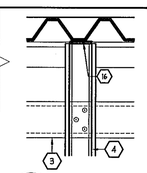

25 DETAIL
A4.1 SCALE: 1"= 1'-0"

ELECTRICAL CONDUIT THROUGH WALL DETAIL

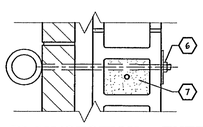

PLAN/SECTION - EYEBOLT
SCALE: 1 1/2" = 1'-0"

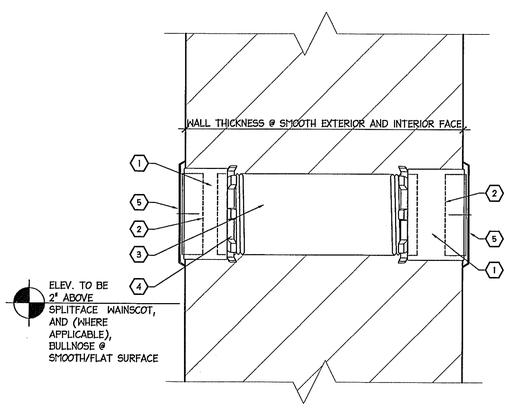

KEYED NOTES

1. FEMALE THREADED COUPLING "EXTENTION" AS REQUIRED TO FINISHED SURFACES TO RECEIVE THREADED PLUG.
2. PVC PLUG. INSTALL W/SILICONE SEALANT ON THREADS (TO BE REMOVED AT TIME OF ELEC WIRE RUN).
3. 4" GALVANIZED OR PVC THREADED SLEEVE TO RECEIVE "STAR" NUTS AND COUPLING "EXTENTIONS" TO FINISHED SURFACES (OR PVC ALTERNATE ACCEPTABLE).
4. "STAR" LOCKING NUT. GROUT SOLID IN PLACE.
5. METAL COVER PLATE.
6. 5/8" GALVANIZED EYEBOLT THROUGH WALL, STEEL WASHER (APPROX. 3-3/4" O.D. X .656" I.D. X .090" THICK OR GREATER), SECURED WITH NUT. LOCATE ADJACENT (EITHER ±2'-0" LEFT OR RIGHT OF THE SLEEVE) AT SLEEVE LEVEL. BY GENERAL CONTRACTOR.
7. CMU FULLY GROUTED W/VERTICAL REBAR.

NOTE: SLEEVE PROVIDED BY ELECTRICAL CONTRACTOR. MASONRY CONTRACTOR TO INSTALL AND COORDINATE WITH ELECTRICAL CONTRACTOR.

26 WALL SECTION AT SLEEVE IN ELECT RM
A4.1 SCALE: 3"= 1'-0"

TYPICAL PHARMACY WALL DETAILS

NOTE: ADAPT THESE DETAILS TO PROJECT REQUIREMENTS

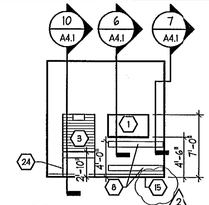

3 ELEVATION ONE
A4.1 SCALE: 1/8"= 1'-0"

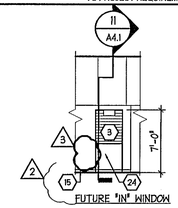

4 ELEVATION TWO
A4.1 SCALE: 1/8"= 1'-0"

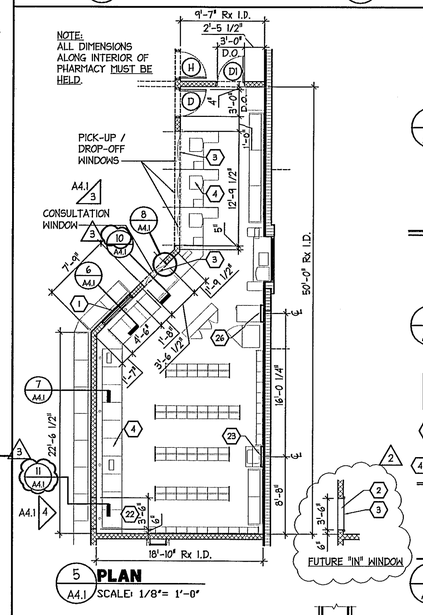

5 PLAN
A4.1 SCALE: 1/8"= 1'-0"

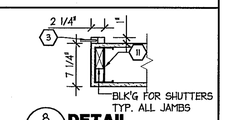

8 DETAIL
A4.1 SCALE: 1"= 1'-0"

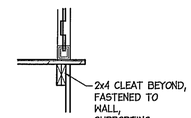

9 DETAIL
A4.1 SCALE: 1" = 1'-0"

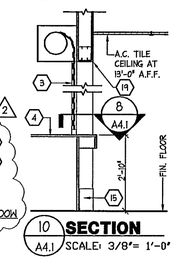

10 SECTION
A4.1 SCALE: 3/8"= 1'-0"

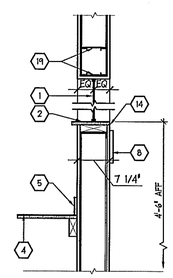

6 DETAIL
A4.1 SCALE: 3/4"= 1'-0"

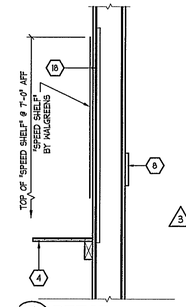

7 DETAIL
A4.1 SCALE: 3/4"= 1'-0"

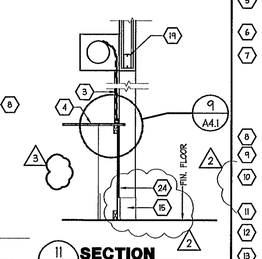

11 SECTION
A4.1 SCALE: 3/8"= 1'-0"

KEYED NOTES

1. 1/4" CLEAR LAMINATED SECURITY GLASS N ALUMINUM FINISH F-SHAPED EXTRUSION (4 SIDES) SIMILAR TO "STYLMARK" #110396. WALL VNYL TO TERMINATE UNDER EXTRUSION.
2. 3/4" THICK WOOD SILL. PLASTIC LAMINATE FINISH WILSON-ART # 2970-6 "WHITE LEATHER", FLUSH W/ WALL FACE.
3. ROLL DOWN SHUTTER BY WALGREENS. (6'-0" OR WIDER SHUTTERS SHALL BE MOTOR OPERATED, LESS THAN 6'-0" WIDE SHALL BE MANUAL).
4. PHARMACY CABINETS BY WALGREENS. (SEE FIXTURE PLAN).
5. 4" BACKSPLASH
6. 1/4" REVEAL PANEL. PAINT BLACK.
7. SUSPENDED CEILING. SEE REFLECTED CEILING PLAN.
8. 1"x8" WOOD GROUNDS.
9. N/A
10. N/A
11. 6" METAL STUDS 24" O.C.
12. 3 5/8" METAL STUDS 24" O.C.
13. 5/8" GWB.
14. "J" BEAD.
15. WALL BASE. SEE INTERIOR ELEVATIONS.
16. WILSON-ART #2970-6 "WHITE LEATHER" PLASTIC LAMINATE. FIELD APPLY TO GWB.
17. CONTINUOUS 2X WOOD NAILER.
18. 3/4" PLYWOOD BETWEEN STUDS FROM 3'-2" TO 7'-2" HIGH A.F.F. SEE A3.1.
19. (2) 16 GA. 6" METAL STUDS. ATTACH TO VERTICAL STUDS AT EACH END.
20. N/A
21. N/A
22. 3'-6"W X 7'-0"H FRAMED OPENING BEHIND DRYWALL FOR FUTURE "IN" WINDOW.
23. 28"W PLUMBING WALL FURR-OUT, USE MOISTURE RESISTANT 5/8" GWB ON 2-1/2" 22 GA MTL STUDS FROM FLOOR TO CLG. PROVIDE (3) PIECES OF 3/4" X 12" X 28"W PLYWD BLK'G CENTERED @ 36", 59" & 80" A.F.F. UNDER GWB FOR MOUNTING OF SINK CABINETS
24. CLOSURE WALL BY WALGREENS. 3/4" PLYWOOD WITH PLASTIC LAMINATE FINISH. (PLASTIC LAMINATE TO EXTEND UP TO TOP OF COUNTER WITH 2X4 TOE CLEAT).
25. N/A
26. 1'-11"W COMMUNICATION CABINET FURR-OUT. PROVIDE 2-1/2" MTL STUDS W/ GWB FROM FLOOR TO CLG

WALL MIRROR DETAILS

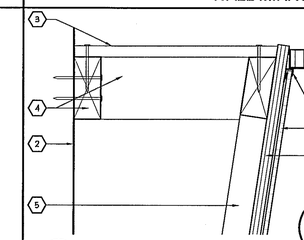

13 DETAIL
A4.1 SCALE: 3 " = 1'-0"

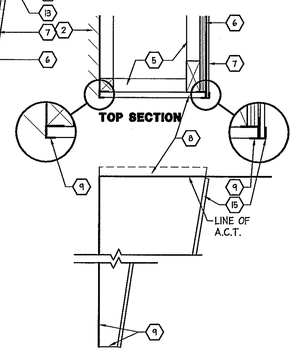

ELEVATION
14 DETAIL - END CAP
A4.1 SCALE: 1 1/2" = 1'-0"

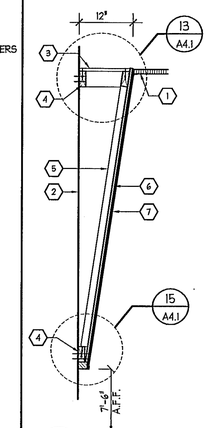

12 DETAIL
A4.1 SCALE: 3/4"= 1'-0"

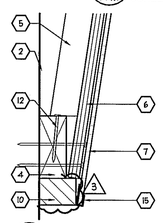

15 DETAIL
A4.1 SCALE: 3 " = 1'-0"

13 TOP TRIM W/ CLEAT

14 VERT. DIVIDER TRIM - SHOWN AT 90 DEGREES

15 BOTTOM "J" CHANNEL

FINISH: SATIN ANODIZED ALUMINUM.
ALUMINUM MIRROR TRIM DETAILS

KEYED NOTES:

1. ACOUSTICAL CEILING TILE.
2. FACE OF WALL.
3. 5/8" PLYWOOD APA EXTERIOR GRADE - SECURE TO 2X4 FRAMING BELOW WITH 2" #10 COARSE SCREWS 8" O.C.
4. 2X4 #1 CONSTRUCTION GRADE. SPOT GLUE AND ANCHOR TO EACH WOOD STUD WITH #10, 3" LONG WOOD SCREWS OR TO EACH METAL STUD WITH 3" LONG SHEET ROCK SCREWS, OR TO MASONRY WITH 2 ROWS C.R. LAURENCE "TAPCON" 1/4" X 3" ANCHORS, 18" O.C. STAGGERED.
5. 2X4 (FLAT) WOOD FRAMING FOR PLYWOOD 16" O.C. "LADDER BACK" FRAME FOR PLYWOOD. SPOT GLUE AND NAIL PLYWOOD TO WOOD FRAMING WITH 8D COATED NAILS 12" O.C.
6. 5/8" PLYWOOD APA EXTERIOR GRADE A/C SEAL COAT EACH FACE AND ALL EDGES WITH CRL PALMER "MIRRO-MASTIC" BOND, PMB401GL.
7. MIRROR - 1/4" PLATE (LOF OR PPG) PANELS ARE TO BE EQUAL WIDTHS. DETERMINE NUMBER OF PANELS USING 2'-6" MINIMUM AND 3'-6" MAXIMUM WIDTHS PER MIRROR PANEL. PROVIDE C.R. LAURENCE-PPG MIRROR EDGE SEALANT AT ALL EDGES. SET MIRROR USING CRL "HEAVY BODIED" MIRROR MASTIC #600GL (NON-ASBESTOS) SCOOPS 18" O.C. EACH WAY WITH ELECTRICAL APPLICATOR. USE C.R. LAURENCE ALUMINUM TOP CHANNEL #D1638A W/ CLEAT #D1637 (FASTEN WITH SCREWS), BOTTOM "J" CHANNEL #D645A AND VERTICAL DIVIDER #D401A. C.R. LAURENCE CO. PHONE: (800) 421-6144.
8. GWB END CAP
9. GWB "J" CHANNEL
10. BOTTOM WOOD RETAINER, 1 1/2" - MILL KILN DRIED TRIM PREMIUM QUALITY. CUT TO DEPTH OF WD TO ALLOW MIRROR TRIM TO PASS BY FACE OF TRIM. FASTEN TO 2X4 WITH 8d FINISH NAILS, 16" O.C. PAINT TO MATCH SOFFIT.
11. N/A.
12. 8d COATED TOE NAILS (ONE EACH SIDE).
13. TOP ALUMINUM TRIM - C.R. LAURENCE #D1638A W/ CLEAT #D1637. FASTEN W/ SCREWS.
14. DIVIDER ALUMINUM TRIM - C.R. LAURENCE #D401A.
15. BOTTOM "J" CHANNEL - CR. LAURENCE #D645A.

FWH Architects, Inc.
3336 Grand Blvd. Suite 102
Holiday, Florida 34690
Ph. 727. 815. 3336
Fax 727. 815. 3337

PROJECT TYPE

DRAWINGS/SPECIFICATIONS BY:
☐ WALGREENS' CONSULTANT
■ LANDLORD'S CONSULTANT

CONSTRUCTION WORK BY: (UNLESS NOTED OTHERWISE)
☐ WALGREENS' CONTRACTOR
■ LANDLORD'S CONTRACTOR (TURNKEY CONSTRUCTION)

STORE		BUILDING	
NEW.....	■	NEW.....	■
REMODELING...	☐	EXISTING.....	☐
RELOCATION...	☐	NEW SHELL ONLY	☐
OTHER.....	☐		

NO.	DATE	DESCRIPTION
1		
2	02.05.10	REVISED PER WGS 1ST REVIEW COMMENTS
3	04.05.10	REVISED PER WGS 2ND REVIEW COMMENTS

REVISIONS

CERTIFICATION AND SEAL

I HEREBY CERTIFY THAT THIS PLAN AND SPECIFICATION WAS PREPARED BY ME OR UNDER MY DIRECT SUPERVISION AND THAT I AM A DULY REGISTERED ARCHITECT OR ENGINEER UNDER THE LAWS OF THE STATE OF FLORIDA AS SIGNIFIED BY MY HAND AND SEAL.

GUY F. FABER
FL LICENSE NO. AR0015323

PROJECT NAME
STORE #13450
(SWC) OF FOURAKER & NORMANDY
JACKSONVILLE, FLORIDA

DRAWING TITLE
ENLARGED Rx PLAN AND DETAILS

DATE: 11.30.09	WALGREENS STORE NO. 13450	DRAWING NO.	
DRAWN BY: AB	SCALE: AS NOTED	A4.1	
REVIEWED BY: SK	RELEASED TO CONSTRUCTION 04.05.10	FWH PROJECT NO. 0913	