STOREFRONT FRAME OPEN'G

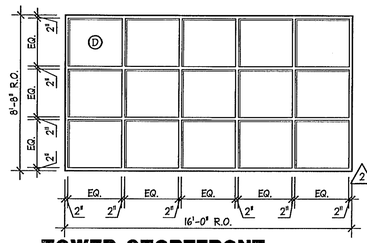

TOWER STOREFRONT
SCALE: 1/4"=1'-0"

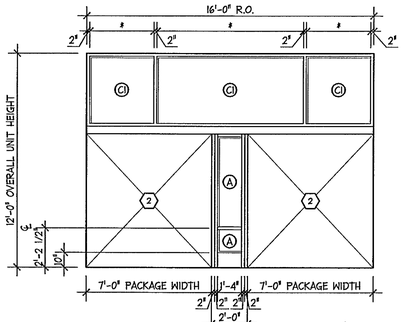

* COORDINATE VERTICAL MULLIONS WITH AUTOMATIC DOOR MANUFACTURER. VERTICAL MULLION TO ALIGN WITH ENTRY DOOR BELOW

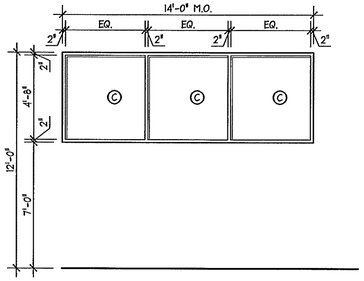

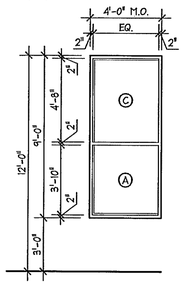

STOREFRONT FRAME
SCALE: 1/4"=1'-0"

AUTOMATIC SLIDING DOOR ENTRANCE DETAIL (TYP)

KEYED NOTES

1. WALGREENS 50"W X 5'H RED TRANSOM DECAL SIGN, 6" HIGH BLACK VINYL STORE ADDRESS DECAL, AND STORE HOURS SIGN BY WALGREENS.
2. AUTOMATIC SLIDING ENTRANCE DOOR, SEE I/A4.3
3. 4" X 2" STL TUBE COLUMNS WRAPPED W/ STOREFRONT MTL, REFER TO STRUCT.
4. 1 3/4" FLUSH CART BARS.
5. N/A
6. "IN EMERGENCY PUSH TO OPEN" DECAL (INSTALL ON MUNTIN BAR, STORE SIDE ONLY).
7. ALUMINUM THRESHOLD, (EXTENDED FULL LENGTH OF OPENING), 1/4" X 4" WIDE X CONTINUOUS RIBBED W/ BEVELED EDGES ACROSS MASONRY OPENING.
8. KEYED ENTRY SWITCH 4'-0" A.F.F. KEY SWITCH TO BE KEYED ALIKE TO THE ADAMS RITE DOOR HOOK LATCH.
9. SEE GENERAL FLOOR PLAN FOR THIS CONSTRUCTION. SEE SHT. D-1.
10. STAINLESS STEEL GUIDE RAIL 30"H X 36"L (CORE DRILLED). PROVIDED BY DOOR MANUFACTURER, INSTALLED BY G.C.
11. RECESSED PULL HANDLE IN MUNTIN BAR, (ENTRY DOOR ONLY). FILL HEAD AND JAMB WITH MORTAR.
12. BASE SET IN SEALANT TAPCON 1/4" X 1 3/4" @ 12" O.C.
13. ANCHORS 18" O.C. 6" FROM ENDS - TYPICAL (USE #4 POWDER DRIVEN @ STEEL, 1/4" W5 @ WOOD, 1/4" TAPCON @ CONCRETE).
14. SECURITY BOLLARDS, REFER TO SHEET C6.2 SIDEWALK PLAN
15. N/A
16. CONTINUOUS .062 OR EXTRUDED ALUMINUM SILL FLASHING, MATCH COLOR.
17. TYPICAL 1/4" BLOCKING BACKER ROD AND MATCHING SEALANT COLOR.

NOTE: COORDINATE FRAMES OF AUTOMATIC DOORS, WINDOW STOREFRONT, AND DRIVE-THRU WINDOW FINISHES TO MATCH.
☐ BRONZE ■ CLEAR ANODIZED ☐ OTHER

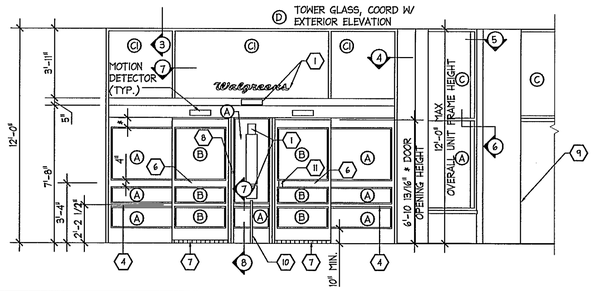

THE AUTOMATIC SLIDING ENTRANCE DOOR FOR THIS PROJECT SHALL BE BY STANELY ACCESS TECHNOLOGIES MODEL #313865. REFER TO SPECIFICATION SECTION 08450. REFER ALSO TO STRUCTURAL DWG'S FOR REINFORCEMENT.

(A) CLEAR LOW-E INSULATED GLASS (LAMINATED SAFETY GLASS-INNER AND OUTER PANE).
(B) 1/4" CLEAR LAMINATED GLASS.
(C) TINTED LOW-E INSULATED GLASS.
(CI) CLEAR LOW-E INSULATED GLASS-TINTED.
(D) TOWER GLASS ABOVE TO BE 1/4" CLEAR.

1/A3 EXTERIOR ELEVATION
SCALE: 1/4"=1'-0"

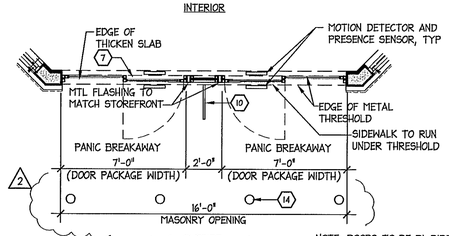

NOTE: DOORS TO BE BI-DIRECTIONAL ACTIVATING WHEN APPROACHED FROM EITHER SIDE.

2/A3 PLAN ENTRANCE DOOR
SCALE: 1/4"=1'-0"

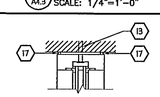

3/A3 DETAIL
SCALE: 1-1/2"=1'-0"

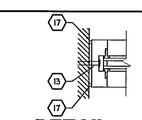

4/A3 DETAIL
SCALE: 1-1/2"=1'-0"

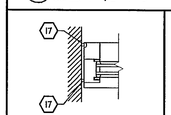

5/A3 DETAIL
SCALE: 1-1/2"=1'-0"

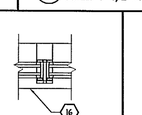

6/A3 DETAIL
SCALE: 1-1/2"=1'-0"

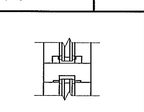

7/A3 DETAIL
SCALE: 1-1/2"=1'-0"

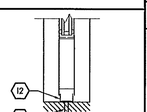

8/A3 DETAIL
SCALE: 1-1/2"=1'-0"

DOOR AND HARDWARE SCHEDULE

1) LOCKING HARDWARE TO USE STANDARD KEYWAYS AND CYLINDERS. LOCKING HARDWARE TO BE KEYED IN THREE SETS: A) PHARMACY DEADBOLTS SHALL BE KEYED ALIKE. B) ALL COMBINATION LOCKSET OVERRIDE KEYS SHALL BE KEYED ALIKE FOR SERVICE. C) ALL OTHER STORE HARDWARE WITH KEYS SHALL BE KEYED ALIKE.
2) FIRE RATING OF DOOR AND FRAME TO BE 90 MIN. LABEL DOOR IN SPACE PROVIDED.
3) SEE FLOOR PLAN FOR DOOR SWINGS.
4) W.O. = WALL OPENING: VERIFY WITH FLOOR PLAN.
5) INSTALL SOUND PROOF GASKET SYSTEM 'PEMKO 588C SILICONSEAL' ON DOOR AND FRAME.
6) UNLESS NOTED OTHERWISE, INTERIOR DOORS ARE WOOD, EXTERIOR DOORS ARE METAL.
7) VISION PANELS:
   A) VISION PANELS TO BE LAMINATED SECURITY GLASS. 4'W X 25"H IN DOORS "A", "B", "BI", AND "E". 15"W X 30"H IN DOORS "D", "H" AND "I".
   B) USE ONE-WAY GLASS AS DESCRIBED: 1) DOOR "D" ALWAYS CLEAR. 2) DOORS ON EXIT AND PUBLIC COORIDORS. 3) DOORS FACING SALES AREA.
   C) REMOVABLE METAL GLASS STOPS TO BE OPPOSITE OF THE SECURE SIDE OF DOOR; EXCEPT PHARMACY TO BE ON SECURE SIDE.
   D) METAL STOPS AND FRAMES TO BE PRIMED AND PAINTED.
   E) FIRE RATED VISION PANELS TO BE USED IN RATED DOORS AS REQUIRED BY CODE.
8) EXIT DOORS: DURING BUSINESS HOURS EXIT DOORS SHALL BE OPERABLE FROM INSIDE WITHOUT USE OF A KEY. HARDWARE SHALL CONFORM TO APPLICABLE ACCESSIBILITY STANDARDS. FIRE DOORS & FRAMES SHALL BE U.L. "B" LABEL RATED 1 1/2 HOURS.
9) NAME PLATES (TOILET ROOMS): COMMERCIAL GRADE A.D.A. COMPLIANT TACTILE SIGN (MEN, WOMEN, & HANDICAPPED). SIGNS TO HAVE BRAILLE, REGULAR COPY AND PICTOGRAPH OF WHEEL CHAIR SIGN TO BE MOUNTED 60" A.F.F. ON WALL AT LATCH SIDE OF DOOR.
10) PROTECTION PLATES: SHALL BE STAINLESS STEEL, 20 GAUGE, US32D FINISH, 52" HIGH WITH OVERLAP TYPE DOOR EDGE PROTECTORS, (STANDARD 18 GAUGE) APPLIED TO BOTH EDGES OF DOOR. MANUFACTURER: ROCKWOOD, (DOOR EDGE, PART #308 AND #309). NOTE: PART #309 IS TO BE APPLIED TO TAPERED EDGE OF DOOR ONLY.
11) KICK PLATES: SHALL BE STAINLESS STEEL WITH US32D FINISH. 10" HIGH AND 2" LESS THAN DOOR WIDTH. MANUFACTURED BY ROCKWOOD OR APPROVED EQUAL. (INSTALL ON PUSH SIDE ONLY.) EXCEPT DOOR "L" TO RECEIVE KICK PLATES ON BOTH SIDES.
12) N/A
13) SALES AREA DOOR CLOSURES TO BE MOUNTED ON SIDE OF DOOR OPPOSITE SALES AREA. OTHER INTERIOR DOOR CLOSERS TO BE MOUNTED ON ROOM SIDE OF DOOR. ATTACH CLOSURE TO DOOR AND ATTACH ARM ASSEMBLY TO FRAME, TYPICAL. ALL CLOSURES SHALL HAVE A MAXIMUM 5 POUNDS PULL PER ADA.
14) UNDERCUT DOOR 1"
15) LATCHING IS REQUIRED FOR FIRE-RATED DOORS. USE SCHLAGE AL105-SAT-626.
16) COMBINATION LOCKSET WITH SERVICE KEY OVERIDE: TRILOGY DL2700 BY ALARM LOCK, 1-800-252-5625 OR MARKS 1QIL/26D. BY MARKS U.S.A. 1-800-526-0233.
17) FOR HIGH SECURITY STORES, ADD PG30 MS-KG W/ PUSH TO EXIT BUTTON, (NON-LATCHED ANNUCIATION ALARM) BY ALRAMLOCK (TO EXIT PASSAGE FROM SALES).
18) DOOR TO MEET HURRICANE WIND LOADS & FLORIDA PRODUCT APPROVAL DATA STATED ON SHEET A0.1
19) VISION PANELS: 15" X 30" PANEL 42"-43" AFF LAM. SECURITY GLASS. APPLY REMOVABLE METAL GLASS STOPS ON SECURE SIDE OF DOOR. PRIME AND PAINT.

LABEL:

TO STOCK ROOM/SALES TO NON-EXIT PASSAGE (LOCKED)

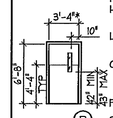

HARDWARE:
HINGES: 1 1/2" PAIR BUTTS, FBB-179 4 1/2" X 4 1/2" PC, STANLEY
LOCK: COMBINATION LOCKSET. NOTE 16.
CLOSER: 7500BFH-M, ALUMINUM NORTON
(B) FLOOR BUMPER: 436B, US26D. IVES
SILENCERS: RUBBER SR64 IVES
(BI) = 3'-0" WIDE

LABEL: REFER TO 1, 2, 3, 6, 7, 10, 13 & 16 ABOVE.

BETWEEN PHARMACY AND PATIENT SEATING

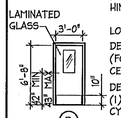

HARDWARE:
HINGES: 1 1/2" PAIR BUTTS, FBB-179 4 1/2" X 4 1/2" PC, STANLEY
LOCK: COMBINATION LOCKSET. NOTE 16.
DEADBOLT: B662P-626, SCHLAGE. (FOR RX W/(2) DOORS ONLY). DEADBOLT CENTERLINE 8" BELOW CYLINDER BORE.
DEADBOLT: B660P-626, SCHLAGE. (FOR RX WITH (1) DOOR) DEADBOLT CENTERLINE 8" BELOW CYLINDER BORE.
CLOSER: 1601BF, ALUMINUM NORTON
FLOOR BUMPER: 436B, US26D. IVES
SILENCERS: RUBBER SR64 IVES
(D)

LABEL: REFER TO 1-3, 6, 7, 11, 13, 14 & 16 ABOVE

BET. PHARMACY/TMULTIPURPOSE ROOM

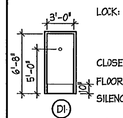

HARDWARE:
HINGES: 1 1/2" PAIR BUTTS, FBB-179 4 1/2" X 4 1/2" PC, STANLEY
LOCK: COMBINATION LOCKSET. NOTE 16 DEADBOLT: B660P-626 SCHLAGE. DEADBOLT CENTERLINE 8" BELOW CYLINDER BORE.
CLOSER: 1601BF, ALUMINUM NORTON
FLOOR BUMPER: 436B, US26D. IVES
SILENCERS: RUBBER SR64 IVES
ONE-WAY VIEWER: #698 190 ALUMINUM IVES
(DI)

LABEL: REFER TO 1-3, 6, 11, 13 & 16 ABOVE

TO ELECTRICAL ROOM

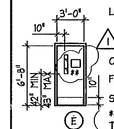

HARDWARE:
HINGES: 1 1/2" PAIR BUTTS, FBB-179 4 1/2" X 4 1/2" PC, STANLEY
LOCKSET: ONE SCHLAGE AL80PD-SAT-626 (STOREROOM FUNCTION) W/ DETECTABLE WARNING KNURLED HANDLE.
CLOSER: 7500DA, ALUMINUM NORTON
FLOOR BUMPER: 436B, US26D. IVES
SILENCERS: RUBBER SR64 IVES
(E)
** PER FIRE MARSHAL A SIGN IS TO BE ADDED TO ELECTRICAL ROOM DOOR STATING: "ELECTRICAL ROOM SERVICE DISCONNECT SWITCH INSIDE"

LABEL: REFER TO 1-3, 6, 7, 11, 13 & 14 ABOVE

TO TOLET ROOM (WITH STALLS)

HARDWARE:
HINGES: 1 1/2" PAIR BUTTS, FBB-179 4 1/2" X 4 1/2" PC, STANLEY
PULL/PLATE: 8305-8, 4" X 16", US26D. IVES
PUSHPLATE: 8200, 4" X 16", US26D. IVES
CLOSER: 1601BF, ALUMINUM NORTON
FLOOR BUMPER: 436B, US26D. IVES
SILENCERS: RUBBER SR64 IVES
(G)

LABEL: REFER TO 2, 3, 6, 9, 11, 13, 14 & 15 ABOVE

TO OFFICE/TRAINING/MULTIPURPOSE ROOM

HARDWARE:
HINGES: 1 1/2" PAIR BUTTS, FBB-179 4 1/2" X 4 1/2" PC, STANLEY
LOCKSET: USE COMBINATION LOCKSET, NOTE 16.
CLOSER: 1601BF, ALUMINUM NORTON
FLOOR BUMPER: 436B, US26D. IVES
SILENCERS: RUBBER SR64 IVES
* ONE-WAY VISION GLASS
(H)

LABEL: REFER TO 1-3, 6, 7, 11, 13 & 16 ABOVE

TO EMPLOYEE ROOM

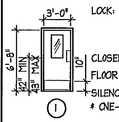

HARDWARE:
HINGES: 1 1/2" PAIR BUTTS, FBB-179 4 1/2" X 4 1/2" PC, STANLEY
LOCK: USE COMBINATION LOCKSET, NOTE 16.
CLOSER: 1601BF, ALUMINUM NORTON
FLOOR BUMPER: 436B, US26D. IVES
SILENCERS: RUBBER SR64 IVES
* ONE-WAY VISION GLASS
(I)

LABEL: REFER TO 2, 3, 6, 7, 11, 13, 14, 15 & 16 ABOVE

TO EXTERIOR

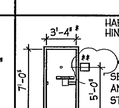

HARDWARE:
HINGES: 1 1/2" PAIR BUTTS, FBB-179 4 1/2" X 4 1/2" PC, STANLEY (NON-REMOVABLE PIN W/ SECURITY STUD)
SECURITY PANIC BAR FOR SECURITY LEVELS 1 AND 2: SUR-LOCK MODEL #1/0 2000L WITH A STANDARD MORTISE CYLINDER.
DORBIN; SWEEP: 83AL, X 40"
RUBBER DORBIN; WEATHER STRIP: 399AV, VINYL DORBIN; ONE-WAY VIEWER: #698 190 ALUMINUM IVES
(J)
* (JI) = 3'-8"
#1 TACTILE EXIT SIGNAGE IS TO BE PROVIDED ON ALL EGRESS DOORS. TACTILE SIGNAGE SHALL COMPLY WITH ICC/ANSI A117.1 AND STATE "EXIT".

LABEL: REFER TO 3, 6, & 8 ABOVE

TO PORTER ROOM

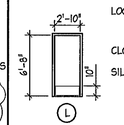

HARDWARE:
HINGES: 1 1/2" PAIR BUTTS, FBB-179 4 1/2" X 4 1/2" PC, STANLEY
LOCKSET: ONE SCHLAGE AL53PD-SAT-626 (ENTRY FUNCTION).
CLOSER: 1601BFH, ALUMINUM NORTON
SILENCERS: RUBBER SR64 IVES
(L)

LABEL: REFER TO 1-3, 6, 11, 13, & 14 ABOVE

LOADING DOCK

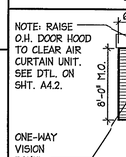

NOTE: RAISE O.H. DOOR HOOD TO CLEAR AIR CURTAIN UNIT. SEE DTL. ON SHT. A4.2.
MIN. 9" CLEAR BOTH SIDES. PROVIDE PERIMETER & HOOD WEATHER SEALS.
PULL CHAIN- CHAIN SIDE IS OPPOSITE CONVEYOR. SEE FIXTURE PLAN.
INDUSTRIAL GRADE (1/4" MINIMUM THICKNESS) SLIDE BOLT FOR PADLOCK EACH SIDE.
(N)

REFER TO 1, 2, 4 & 6 ABOVE

TOWER ACCESS

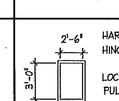

HARDWARE:
HINGES: 1 1/2" PAIR BUTTS, FBB-179 4 1/2" X 4 1/2" PC, STANLEY
LOCK: DEADBOLT: B660P-626 SCHLAGE.
PULL: 8121, US26D, IVES
CLOSER: 1601BF, ALUMINUM NORTON
WEATHER STRIP: 399S, VINYL DORBIN OR EQUAL, ALL AROUND FRAME
(R)

REFER TO 1-3, 6 & 15 ABOVE

COMPACTOR CHUTE

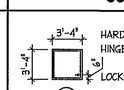

HARDWARE:
HINGES: PAIR OF SPRING LOADED HINGES, STANLEY, 2060RUSP
LOCKSET: ONE SCHLAGE AL25D-SAT-626
WEATHER STRIP: 399S, VINYL DORBIN OR EQUAL, ALL AROUND FRAME
* COMPACTOR DOOR TO BE 90 MINUTE FIRE RATED
(T)

LABEL: REFER TO 2, 3, 4, 6 & 18 ABOVE

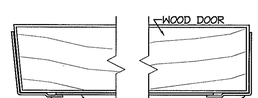

17/A3 DETAIL
SCALE: 6"=1'-0" REFER TO 10

FWH Architects, Inc.
3336 Grand Blvd. Suite 102
Holiday, Florida 34690
Ph. 727. 815. 3336
Fax 727. 815. 3337

PROJECT TYPE

DRAWINGS/SPECIFICATIONS BY:
☐ WALGREENS' CONSULTANT
■ LANDLORD'S CONSULTANT

CONSTRUCTION WORK BY: (UNLESS NOTED OTHERWISE)
☐ WALGREENS' CONTRACTOR
■ LANDLORD'S CONTRACTOR (TURNKEY CONSTRUCTION)

STORE		BUILDING	
NEW.....	■	NEW.....	■
REMODELING...	☐	EXISTING.....	☐
RELOCATION...	☐	NEW SHELL ONLY	☐
OTHER.....	☐		

NO.	DATE	DESCRIPTION
1	01.08.10	REVISED PER COJ PLAN REVIEW COMMENTS
2	02.05.10	REVISED PER WGS 1ST REVIEW COMMENTS
3	04.05.10	REVISED PER WGS 2ND REVIEW COMMENTS

REVISIONS

CERTIFICATION AND SEAL

I HEREBY CERTIFY THAT THIS PLAN AND SPECIFICATION WAS PREPARED BY ME OR UNDER MY DIRECT SUPERVISION AND THAT I AM A DULY REGISTERED ARCHITECT OR ENGINEER UNDER THE LAWS OF THE STATE OF FLORIDA AS SIGNIFIED BY MY HAND AND SEAL.

GUY F. FABER
FL LICENSE NO. AR0015823

PROJECT NAME
STORE #13450
(SWC) OF FOURAKER & NORMANDY
JACKSONVILLE, FLORIDA

DRAWING TITLE
DOOR SCHEDULE AND NOTES

DATE:	11.30.09	WALGREENS STORE NO. 13450	DRAWING NO. A4.3
DRAWN BY:	AB	SCALE: AS NOTED	
REVIEWED BY:	SK	RELEASED TO CONSTRUCTION 04.05.10	FWH PROJECT NO. 0913