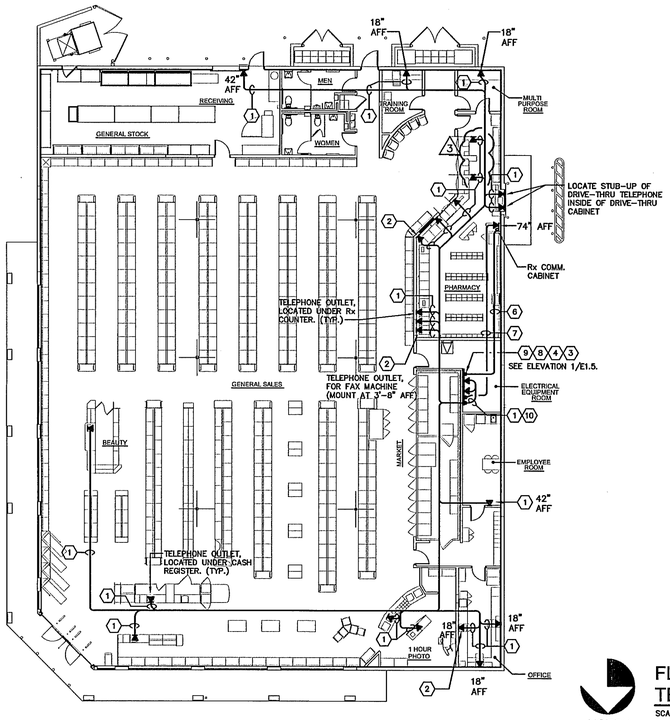

NORTH

FLOOR PLAN
TELEPHONE SYSTEM

SCALE: 1/16" = 1'-0"

TELEPHONE SYSTEM KEYED NOTES

1. 3/4" CONDUIT SHALL BE PROVIDED AS REQUIRED PER NOTES AND/OR STATE AND LOCAL CODES.
2. TELEPHONE POWER FAILURE JACKS ARE TELEPHONE OUTLETS WHICH BYPASS THE NORSTAR SYSTEM AND ARE USED DURING ELECTRICAL POWER INTERRUPTIONS. THE TELEPHONE POWER FAILURE JACKS ARE WIRED DIRECTLY TO THE STATION BLOCKS. TELEPHONE POWER FAILURE JACKS ARE LOCATED IN THE PHARMACY AND THE OFFICE.
3. THE CONTRACTOR SHALL FURNISH AND INSTALL A 8' X 8', 3/4" A-C GRADE PLYWOOD (TREATED PER CODE) FOR TELEPHONE BOARD MOUNTING.
4. THE CONTRACTOR SHALL FURNISH AND INSTALL CONDUITS AND PULLWIRE AS SHOWN ON SHEET E0.1, FROM THE PROPERTY LINE, OUTSIDE THE BUILDING, AND TERMINATE AT THE TELEPHONE TERMINAL BOARD.
5. NOT USED.
6. CABLE LABELED (C) CATEGORY 3 (25 PAIR) FURNISHED AND INSTALLED BY WALGREEN'S CONTRACTOR. FROM RX COMMUNICATION CABINET TO ELECTRICAL EQUIPMENT ROOM, CONDUIT BY LANDLORD'S CONTRACTOR.
7. THE LANDLORD'S CONTRACTOR SHALL PROVIDE A 1" CONDUIT FROM THE TELEPHONE TERMINAL BOARD TO THE Rx COMMUNICATIONS CABINET. WALGREENS CONTRACTOR SHALL FURNISH AND INSTALL A THREE (3) PAIR (MIN.) TELEPHONE CABLE AND AN ADDITIONAL #12 PULLSTRING (FOR DTR USE) IN THAT CONDUIT. THE THREE (3) TERMINATED BY A 8TR PAIR (MIN.) TELEPHONE CABLE WILL BE (DATA TERMINAL REPAIR) TECHNICIAN AT THE TELEPHONE TERMINAL BOARD.
8. SEE DRAWING E0.1 FOR UTILITY SERVICE ENTRANCE LOCATION.
9. ELECTRICAL CONTRACTOR TO FURNISH AND INSTALL "ORTRONICS" GB4X12J GROUNDING BUS. (CALL ANIXTER @ (847) 390-4530).
10. TWO (2) TELEPHONE LINES FOR THE FIRE ALARM SYSTEM (IF REQUIRED BY CODE). FIRE ALARM CONTROL PANEL IS LOCATED AT THE TELEPHONE TERMINAL BOARD. SEE DRAWING E1.6 FOR ADDITIONAL INFORMATION.

LEGEND

- TELEPHONE OUTLET
- JUNCTION BOX IN NEAREST WALL
- JUNCTION BOX UNDERNEATH FIXTURE

TELEPHONE TERMINAL BOARD ELEVATION

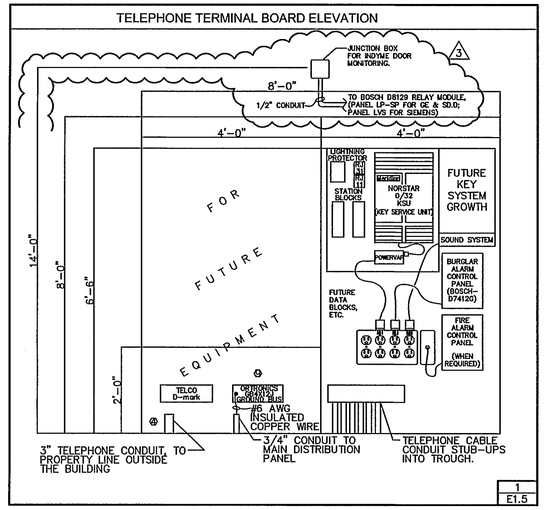

1
E1.5

TELEPHONE SYSTEM NOTES

2

1. THE GENERAL CONTRACTOR/DEVELOPER SHALL COORDINATE THE INSTALLATION OF TELEPHONE CABLE (25 PAIR MINIMUM) TO TELEPHONE BOARD. GENERAL CONTRACTOR SHALL PLACE ORDER WITH THE DOMINANT CARRIER IN THE MARKET (QWEST, BELL SOUTH, SBC, VERIZON AND SPRINT) AT LEAST 90 DAYS IN ADVANCE OF FIXTURE DATE. DO NOT PLACE ORDERS WITH A COMPETITIVE LOCAL EXCHANGE CARRIER (CLEC) AS THIS WILL DELAY COPPER CABLE INSTALLATIONS. IF THE TELEPHONE COMPANY SUGGESTS TWO (2) SIX-PAIR CABLES OR SEEMS RELUCTANT TO PROCEED WITH THE ORDER IN A TIMELY MANNER, CONTACT WALGREENS TELECOMMUNICATIONS DEPARTMENT (224-542-6067), AS SOON AS POSSIBLE.
2. ALL WORK SHOWN SHALL COMPLY WITH ALL NATIONAL, STATE AND LOCAL CODES, ORDINANCES, ETC.
3. TELEPHONE WIRING TO BE FURNISHED AND INSTALLED BY WALGREEN'S CONTRACTOR. CONDUIT AND #12 PULL STRING IS FURNISHED AND INSTALLED BY LANDLORD'S CONTRACTOR.
4. NOT USED.
5. TELEPHONE CABLES SHALL NOT BE PLACED OR ROUTED OVER FLUORESCENT FIXTURES OR BALLASTS.
6. NO EXPOSED TELEPHONE CABLES ARE PERMITTED IN THE SALES AREA.

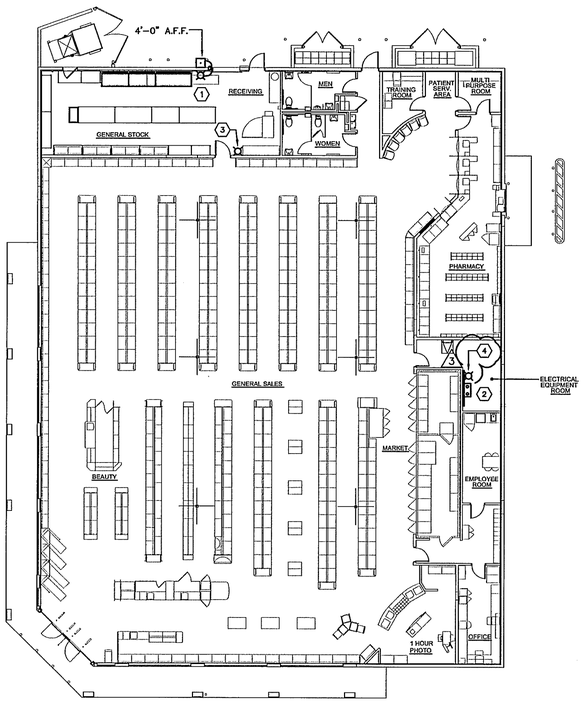

NORTH

FLOOR PLAN
SOUND SYSTEM

SCALE: 1/16" = 1'-0"

SOUND SYSTEM NOTES

1. ALL WORK SHOWN SHALL COMPLY WITH ALL NATIONAL, STATE AND LOCAL CODES, ORDINANCES, ETC.
2. FOR COORDINATION PURPOSES SPEAKER LOCATIONS SHOWN ON REFLECTED CEILING PLAN, DRAWING A1.2.

SOUND SYSTEM KEYED NOTES

1. LANDLORD'S CONTRACTOR SHALL FURNISH AND INSTALL WEATHER-PROOF PUSHBUTTON (EDWARDS #1785 OR #852) WIRED WITH #18 AWG, ROUTED IN A CONDUIT AND TERMINATED IN A JUNCTION BOX MOUNTED 10'-0" A.F.F.. PROVIDE 5'-0" OF CABLE SLACK. MOUNT PUSHBUTTON @ 4'-0" A.F.F., ADJACENT TO ROLL-UP RECEIVING DOOR. FINAL TERMINATION OF INDYME REMOTE RECEIVER BY WALGREEN'S CONTRACTOR/DTR.
2. SOUND SYSTEM RECEIVER, FURNISHED AND INSTALLED BY WALGREENS. SEE DETAIL 1/E1.5, ABOVE.
3. PROVIDE (2) JUNCTION BOXES, ONE MOUNTED AT 5'-0" A.F.F. (FOR PAGING HORN VOLUME CONTROL, BY WALGREENS) AND THE OTHER JUNCTION BOX MOUNTED AT 9'-0" A.F.F. (FOR PAGING HORN, BY WALGREENS). PROVIDE CONDUIT BETWEEN TWO JUNCTION BOXES FOR CABLE ROUTING MEANS.
4. PROVIDE ONE (1) JUNCTION BOX MOUNTED 14'-0" A.F.F. (DIRECTLY ABOVE TELEPHONE TERMINAL BOARD) WITH 1/2" CONDUIT ROUTED TO PANEL LP-SP (FOR GE AND SQ.D) OR PANEL LVS (FOR SIEMENS) FOR INDYME DOOR MONITORING. LOW VOLTAGE CABLING (BELDEN 5306 FE, SHIELDED) SHALL BE FURNISHED AND INSTALLED BY WALGREENS CONTRACTOR. FINAL TERMINATION BY WALGREENS DTR.

2

LEGEND

- PUSHBUTTON
- SOUND SYSTEM (MOUNTED ADJACENT TO TELEPHONE BOARD)
- PAGING HORN (WALL MOUNTED 9'-0" A.F.F.), WITH SEPARATE VOLUME CONTROL UNIT (WALL MOUNTED 5'-0" A.F.F.), BY WALGREENS CONTRACTOR/DTR.

FWH Architects
3336 Grand Blvd. Suite 102
Holiday, Florida 34690
Ph. 727. 815. 3336
Fax 727. 815. 3337
Lic.# AA 0003300

PROJECT TYPE

DRAWINGS/SPECIFICATIONS BY:
- ☐ WALGREENS' CONSULTANT
- ■ LANDLORD'S CONSULTANT

CONSTRUCTION WORK BY: (UNLESS NOTED OTHERWISE)
- ☐ WALGREENS' CONTRACTOR
- ■ LANDLORD'S CONTRACTOR (TURNKEY CONSTRUCTION)

STORE		BUILDING	
NEW.....	■	NEW.....	■
REMODELING...	☐	EXISTING.....	☐
RELOCATION...	☐	NEW SHELL ONLY	☐
OTHER.....	☐		

CHEHAYEB & ASSOCIATES, INC.
CONSULTING ENGINEERS
3702 AZEELE ST. TAMPA, FL 33609
(813) 876-1415 (fax) 876-0913
LIC. #49521 SOUHEIL CHEHAYEB CERT. #7340
09-97

NO.	DATE	DESCRIPTION
2	02.05.10	REVISED PER WGS FIRST REVIEW COMMENTS
3	04.05.10	REVISED PER WGS 2ND. REVIEW COMMENTS

REVISIONS

CERTIFICATION AND SEAL

I HEREBY CERTIFY THAT THIS PLAN AND SPECIFICATION WERE PREPARED BY ME OR UNDER MY DIRECT SUPERVISION AND THAT I AM A DULY REGISTERED ARCHITECT OR ENGINEER UNDER THE LAWS OF THE STATE OF FLORIDA AS SIGNIFIED BY MY HAND AND SEAL.

PROJECT NAME

STORE #13450
SWC OF FOURAKER & NORMANDY
JACKSONVILLE, FLORIDA

DRAWING TITLE

FLOOR PLAN - TELEPHONE & SOUND SYSTEM

DATE: 11.30.09	WALGREENS STORE NO. 13450	DRAWING NO.	
DRAWN BY: P.M.	SCALE: AS SHOWN	E1.5	
REVIEWED BY: S.C.	RELEASED TO CONSTRUCTION -	FWH PROJECT NO. 0913	