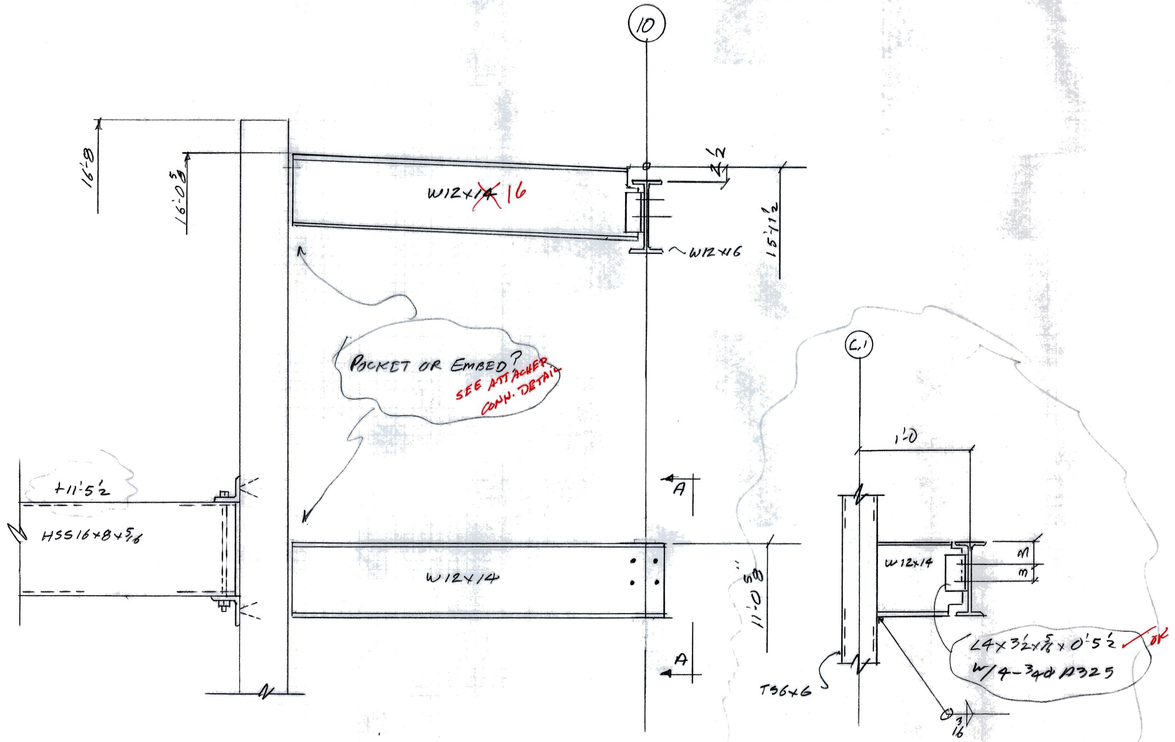

1 ES SECTION

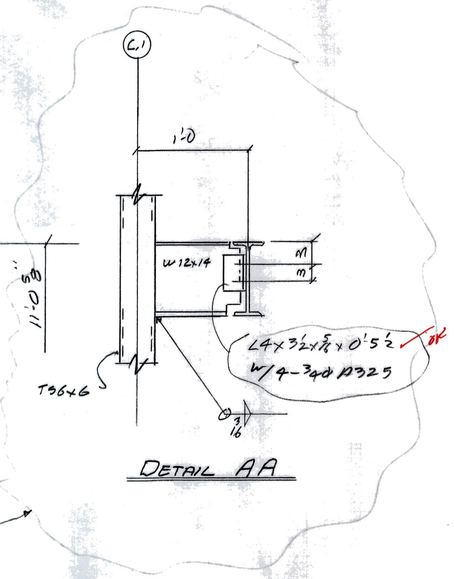

DETAIL AA

VERIFY

FOR APPROVAL ONLY

☐ NO EXCEPTIONS
☐ REJECTED
☐ SUBMIT SPECIFIED ITEM
☒ MAKE CORRECTIONS NOTED
☐ REVISE AND RESUBMIT

MAR 25 2010

Checking is only for general conformance with the design concept of the project and general compliance with the information given in the contract documents. Corrections or comments made on the shop drawings during this review do not relieve the contractor from compliance with requirements of the drawings and specifications. Contractor is responsible for dimensions which have not confirmed and correlation of the job site fabrication processes and techniques of construction, coordination of his work with that of all other trades and satisfactory performance of his work.
Reviewed by: MLS SCA

REVISIONS

FABRICATED PRODUCTS OF TAMPA, INC.
PH. (813) 247-6024
1700 2nd AVE. E
TAMPA, FLA. 33605

PROJECT BANK FIRST
LOCATION OVIEDO FL
CUSTOMER R-D MICHAELS
ARCH. OR ENG MC CLEARY GERMAN
DWG. COVER

DRAWN	DATE	CHK'D	DATE		
PAINT	HOLES	WELD	JOB NO.	DWG. NO.	
GRAY	NOTED	E70XX	10-09	ES	